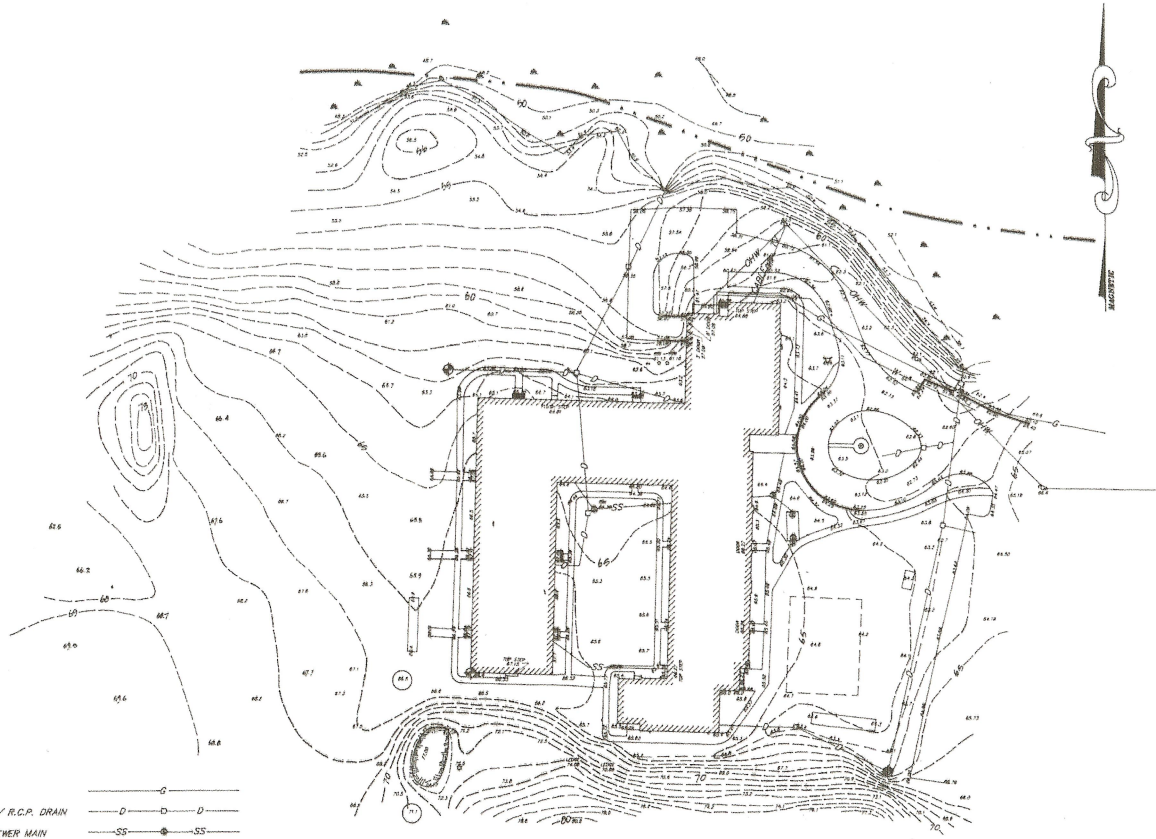

LEGEND:

EXISTING GAS MAIN	G
EXISTING CATCH BASIN / R.C.P. DRAIN	D D
EXISTING S.M.H./SAN. SEWER MAIN	SS SS
EXISTING OVERHEAD ELECTRIC/ UTILITY LINE(S)	OHW
EXISTING WATER MAIN	W
EXISTING FIRE HYDRANT	
EDGE OF WETLANDS	

THE LOCATION OF UNDERGROUND UTILITIES SHOWN HEREON ARE ESTABLISHED BY REFERENCE TO PUBLIC RECORDS AVAILABLE. SUCH UTILITIES MAY BEAR A RELATIVE TO THE SURFACE MARKINGS, OTHERWISE THEY DISAPPEAR ON THE GROUND, AND ALSO BY THE RECORD PLANS AND INFORMATION FOR UNDERGROUND INSTALLATIONS OBTAINED FROM THE RESPECTIVE UTILITY COMPANIES. THE LOCATIONS OF UTILITIES SHOWN HEREON ARE AS THEY APPEAR DESIGNED TO EXISTS ON THE GROUND, OR AS SHOWN BY THE RECORD PLANS AND INFORMATION OBTAINED FROM THE RESPECTIVE UTILITY COMPANIES. WE DO NOT WARRANT THAT THE UTILITIES SHOWN HEREON ARE THE ONLY UTILITIES ON THE SITE, BUT ONLY THOSE WHICH WERE DISCOVERED BY A SURVEY THE COURSE OF OUR FIELD SURVEY OF NOTED BY THE RESPECTIVE UTILITY COMPANIES IN THEIR RECORDS AS PERTAINING TO THE SITE. THE LOCATIONS OF UTILITIES SHOWN HEREON MAY NOT BE SHOWN HEREON, SHALL BE VERIFIED IN THE FIELD BY THE RESPECTIVE UTILITY COMPANY PRIOR TO DESIGNING, EXCAVATING, BORING OR OTHER CONSTRUCTION ACTIVITY. THE CONTRACTOR MUST CONTACT THE RESPECTIVE UTILITY COMPANIES FOR SERVICE CONNECTIONS. THE APPROPRIATE PUBLIC UTILITY ENGINEERING DEPARTMENT MUST BE CONTACTED. HUNT ENGINEERING ASSOCIATES, INC. AND PAUL J. TURNER, P.E., P.L.S. ASSUME NO RESPONSIBILITY FOR DAMAGES WHICH MAY BE THE RESULT OF UTILITIES OMITTED OR INCORRECTLY SHOWN HEREON.

VERTICAL DATUM: 1929
STARTING BENCHMARK: "V-3
OF CONCRETE ABUTTMENT ON